


PRICHARD CREEK RESTORATION PROJECT

PHASE 1 AS-BUILT

SHOSHONE COUNTY, IDAHO
JANUARY 2024

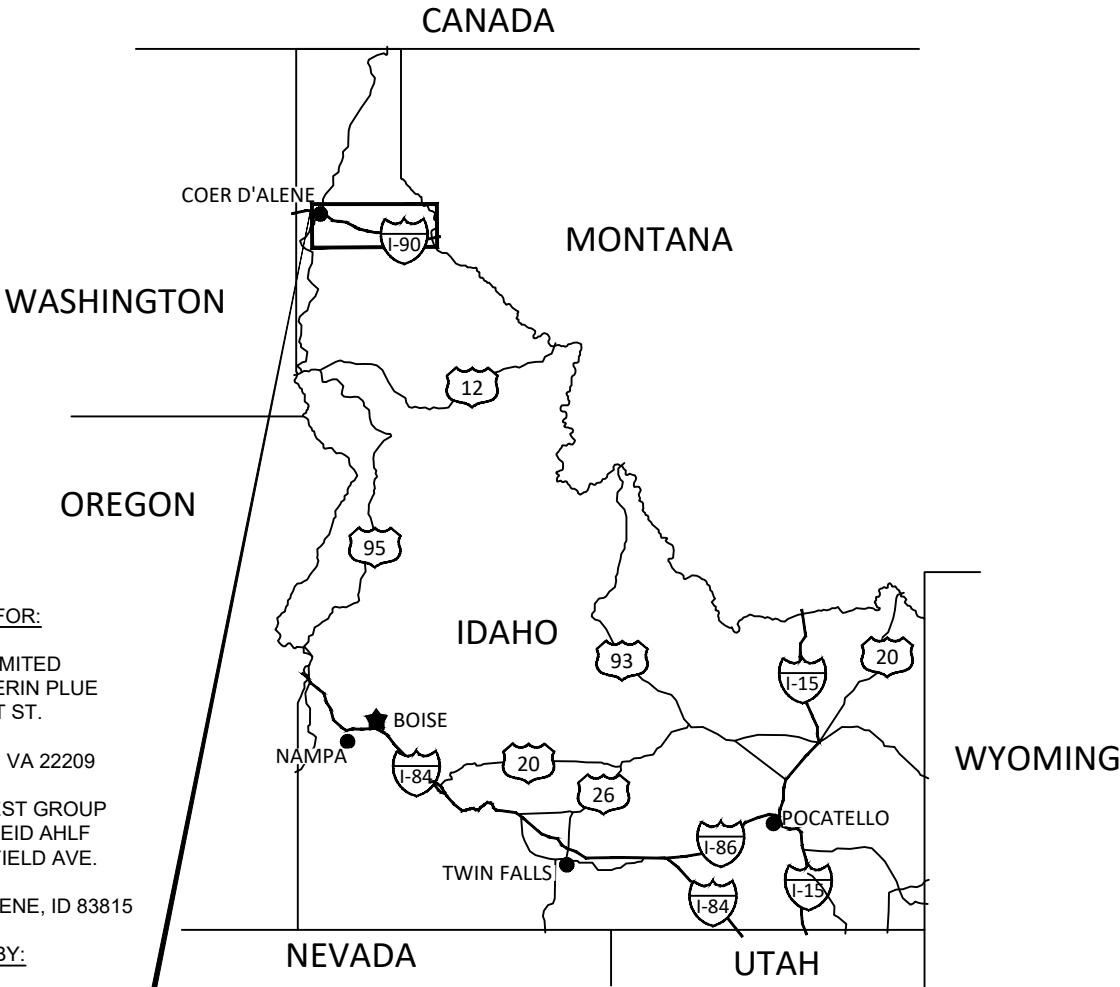


PREPARED FOR:

TROUT UNLIMITED
CONTACT: ERIN PLUE
1777 N. KENT ST.
SUITE 100
ARLINGTON, VA 22209

IDAHO FOREST GROUP
CONTACT: REID AHLF
687 W. CANFIELD AVE.
SUITE 101
COEUR D'ALENE, ID 83815

PREPARED BY:

INTER-FLUVE
CONTACT: LUKE SWAN
501 PORTWAY AVE.
SUITE 101
HOOD RIVER, OR 97031

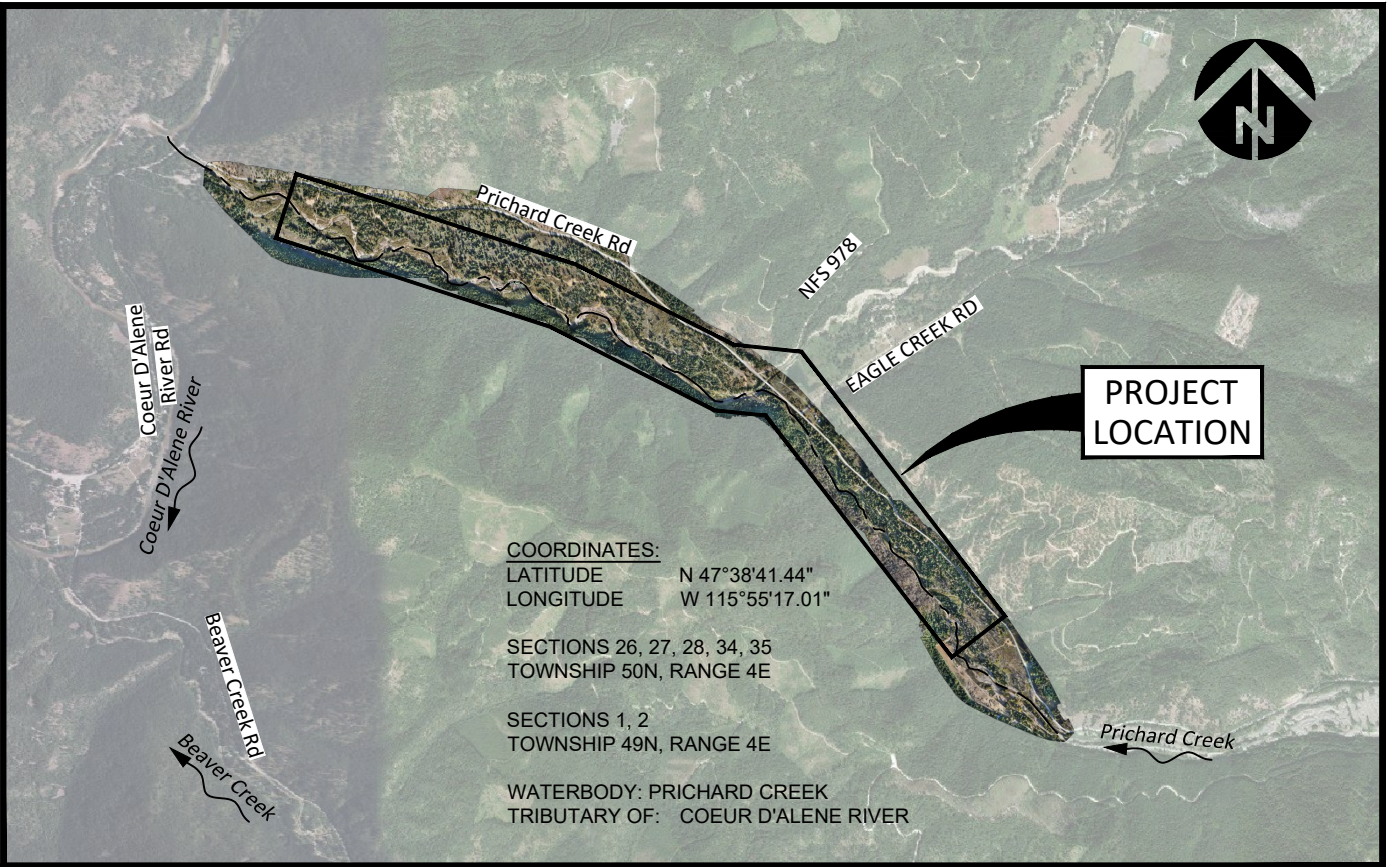


COORDINATES:
LATITUDE N 47°38'41.44"
LONGITUDE W 115°55'17.01"

SECTIONS 26, 27, 28, 34, 35
TOWNSHIP 50N, RANGE 4E

SECTIONS 1, 2
TOWNSHIP 49N, RANGE 4E

WATERBODY: PRICHARD CREEK
TRIBUTARY OF: COEUR D'ALENE RIVER

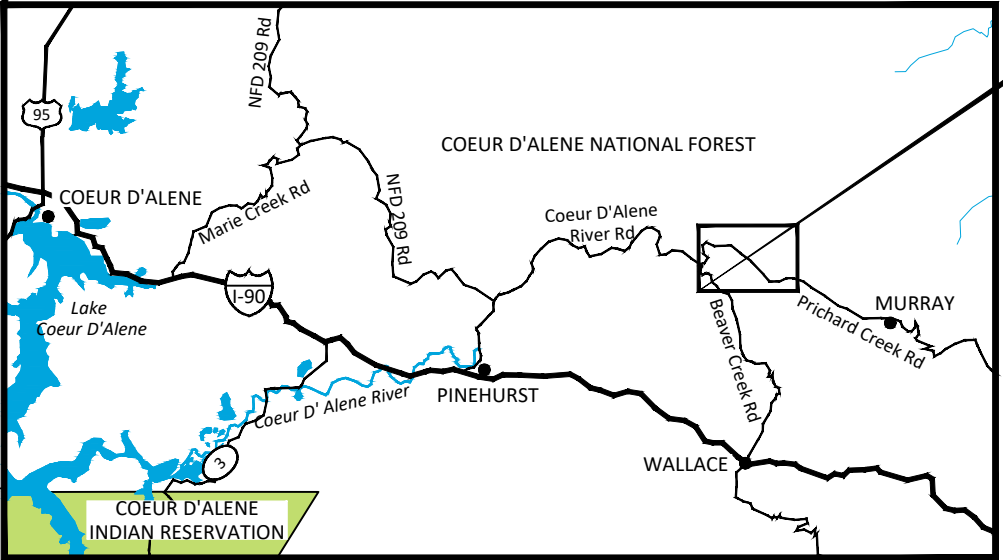

SHEET INDEX

- 1 COVER, VICINITY AND SHEET INDEX
- 2 PROPOSED PROJECT AREAS OVERVIEW
- 3 AS-BUILT PROJECT AREA 1
- 4 AS-BUILT PROJECT AREA 2 (1 OF 3)
- 5 AS-BUILT PROJECT AREA 2 (2 OF 3)
- 6 AS-BUILT PROJECT AREA 2 (3 OF 3)
- 7 AS-BUILT PROJECT AREA 3
- 8 AS-BUILT PROJECT AREA 4

NO.	BY	DATE	REVISION DESCRIPTION

CM DRAWN	LS, MC, SE DESIGNED	LS CHECKED
MC APPROVED	3/18/2024 DATE	210257 PROJECT



PRICHARD CREEK
RESTORATION PROJECT
PHASE 1 AS-BUILT




501 Portway Avenue, Suite 101
Hood River, OR 97031
541.386.9003
www.interfluve.com

COVER, VICINITY AND SHEET INDEX

SHEET

1 OF 8

G:\M:\P\PrichardCreek\Phase1\Design - 210257\Drawings\AS-Built\PrichardCreek.dwg - bbroderick - 3/19/24

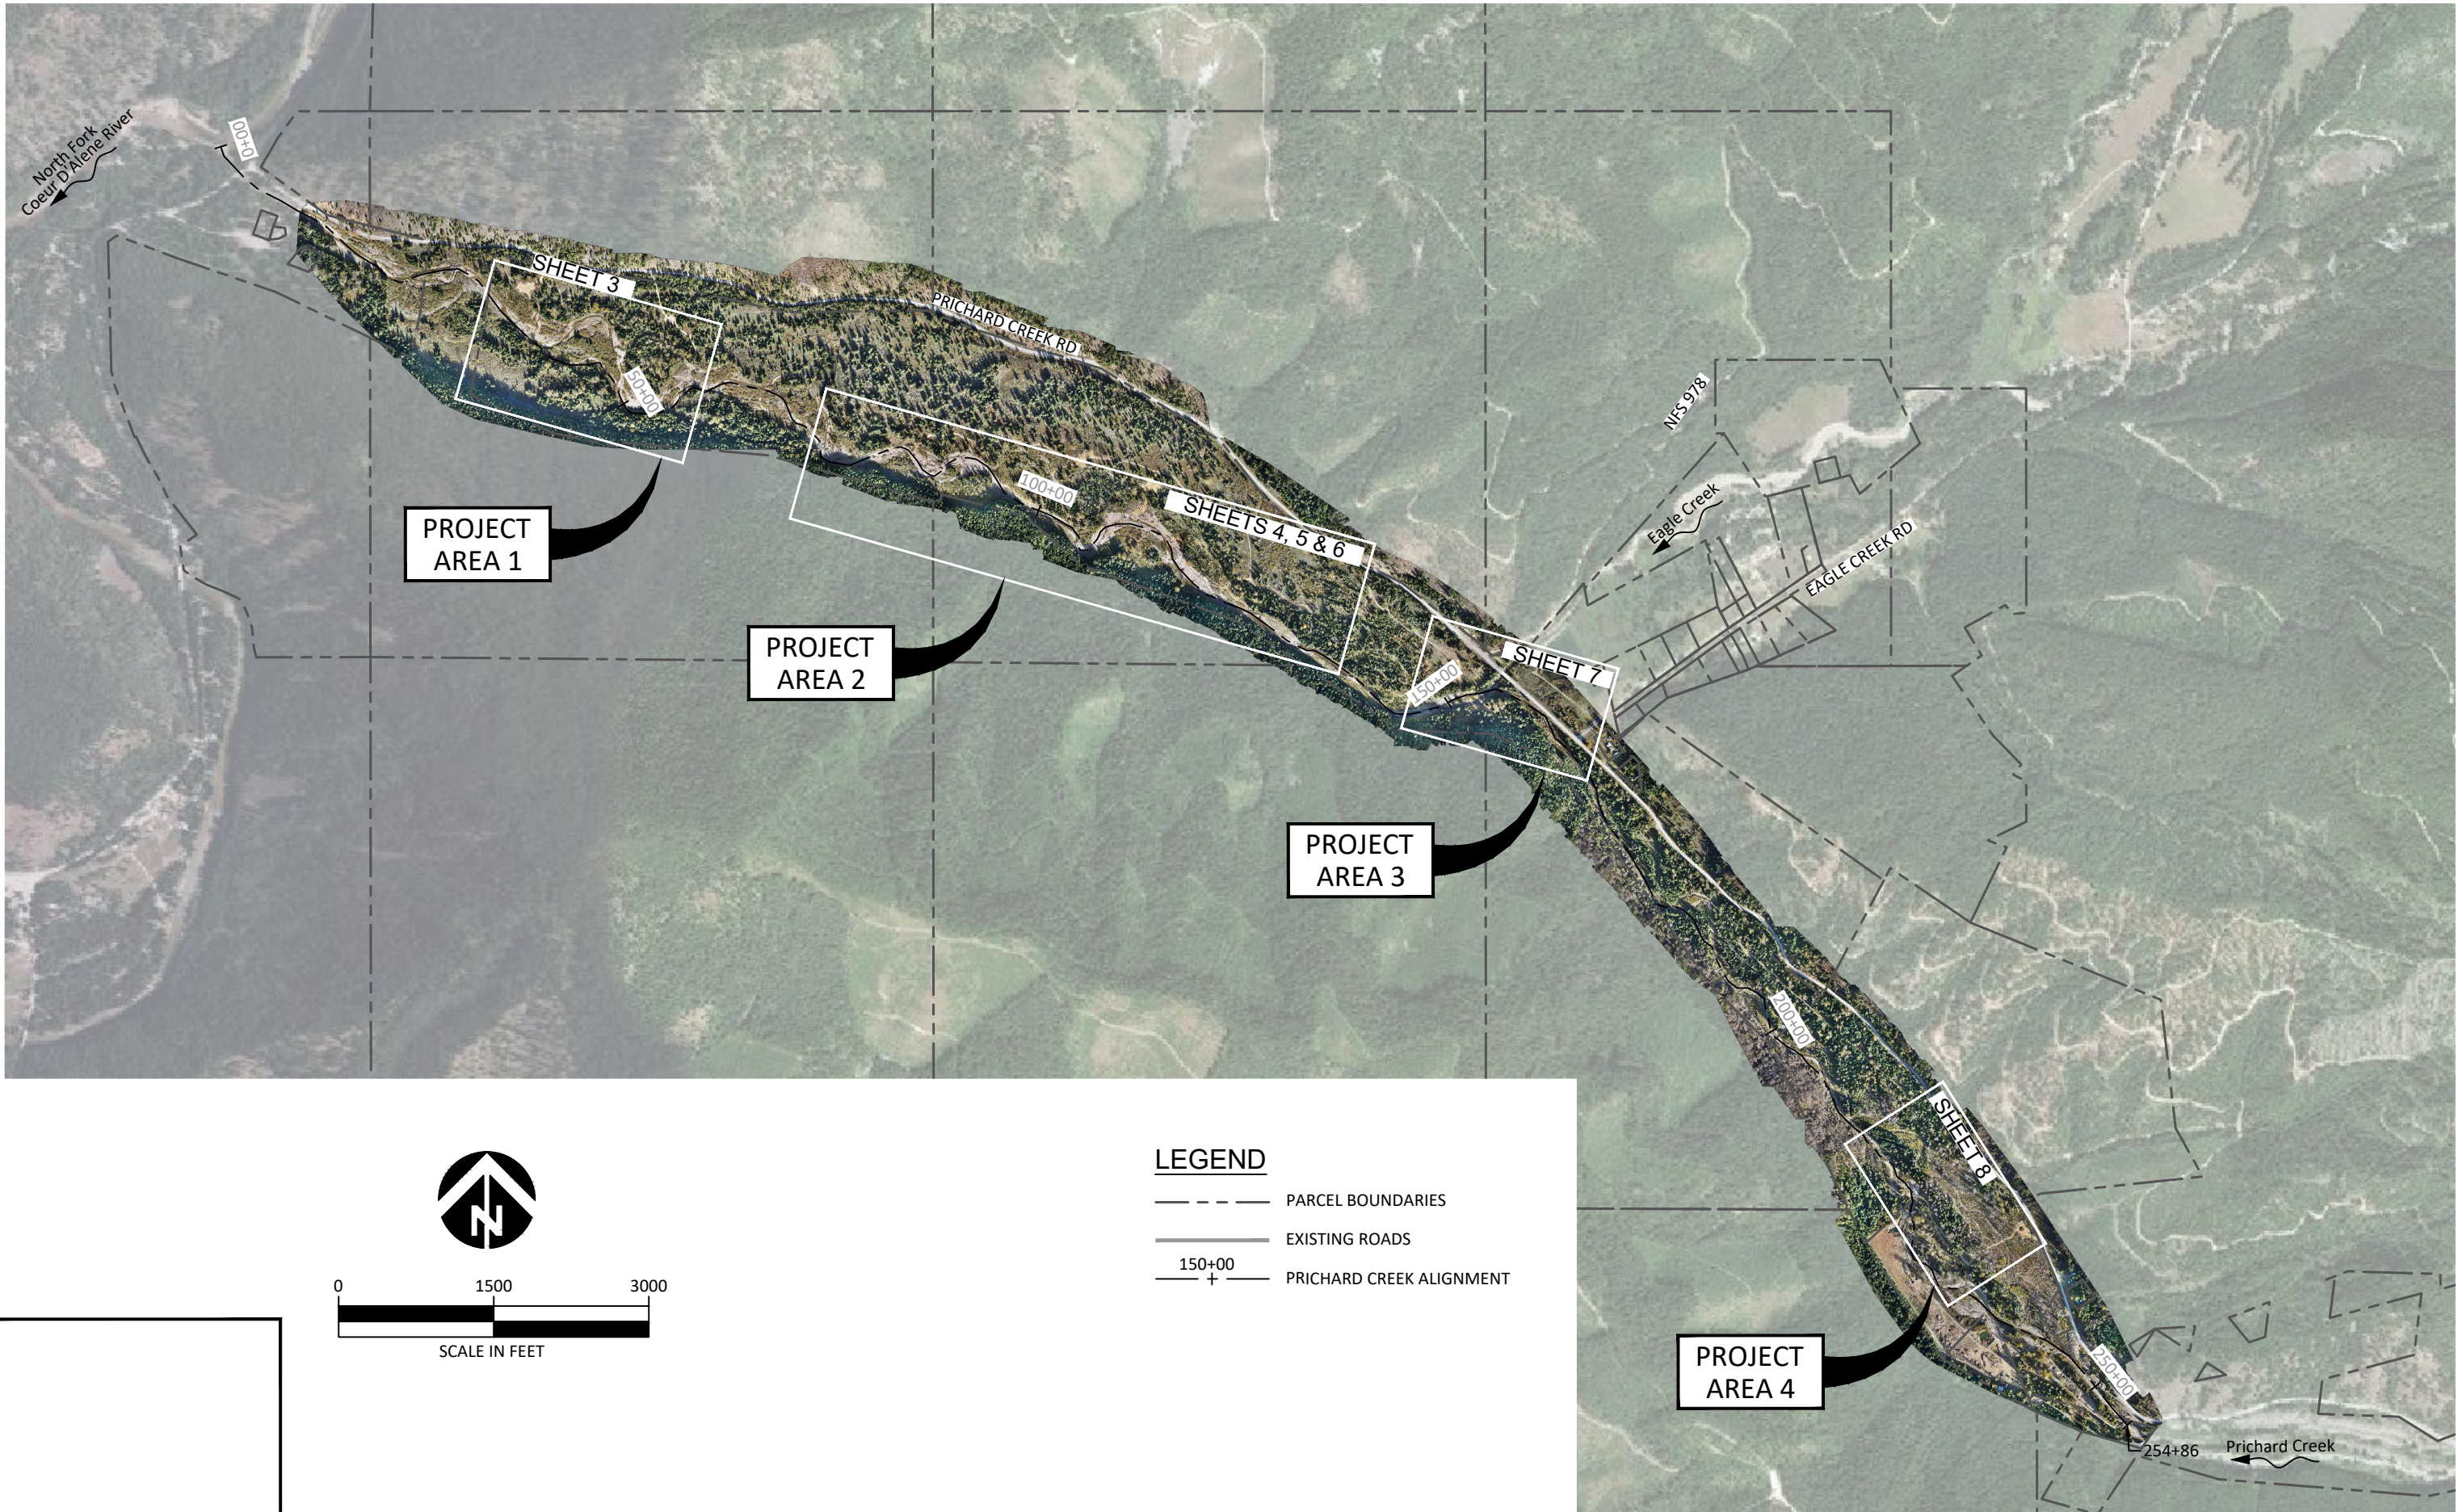

G:\M:\P\PrichardCreek\PH1\Design - 210257\Drawings\As-Built\PrichardCreek.dwg - bbroderick - 3/19/24

NO.	BY	DATE	REVISION DESCRIPTION

CM	LS, MC, SE	LS
DRAWN	DESIGNED	CHECKED
MC	3/18/2024	210257
APPROVED	DATE	PROJECT




PRICHARD CREEK
RESTORATION PROJECT
PHASE 1 AS-BUILT



501 Portway Avenue, Suite 101
Hood River, OR 97031
541.386.9003
www.interfluve.com

PROPOSED PROJECT
AREAS OVERVIEW

SHEET
2 OF 8

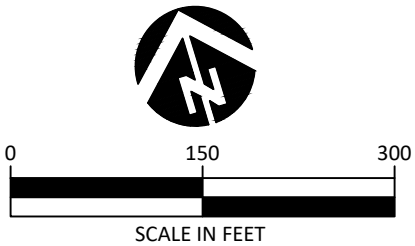

- LEGEND**
- PARCEL BOUNDARIES
 - EXISTING ROADS
 - 150+00
+ PRICHARD CREEK ALIGNMENT
 - BAR REVEGETATION AREA

ABBREVIATIONS:

BB- BANK BURIED
CS- CHANNEL SPANNING
DFL- DEFLECTOR
BRA- BAR REVEGETATION AREA

G:\M:\P\PrichardCreek\PH1\Design - 210257\Drawings\AS-Built\PrichardCreek.dwg - bbroderick - 3/19/24

NO.	BY	DATE	REVISION DESCRIPTION

CM	LS, MC, SE	LS
DRAWN	DESIGNED	CHECKED
MC	3/18/2024	210257
APPROVED	DATE	PROJECT



PRICHARD CREEK
RESTORATION PROJECT
PHASE 1 AS-BUILT




501 Portway Avenue, Suite 101
Hood River, OR 97031
541.386.9003
www.interfluve.com

AS-BUILT PROJECT AREA 1

SHEET
3 OF 8

G:\M:\P\PrichardCreek\1Design - 210257\Drawings\AS-built\PrichardCreek.dwg - bbroderick - 3/19/24

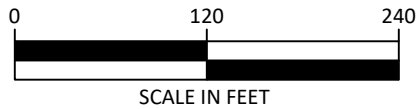

ABBREVIATIONS:

BB- BANK BURIED
CS- CHANNEL SPANNING
DFL- DEFLECTOR
BRA- BAR REVEGETATION AREA

LEGEND

- PARCEL BOUNDARIES
- EXISTING ROADS
- 150+00
+ PRICHARD CREEK ALIGNMENT
- BRA BAR REVEGETATION AREA

NO.	BY	DATE	REVISION DESCRIPTION

CM	LS, MC, SE	LS
DRAWN	DESIGNED	CHECKED
MC	3/18/2024	210257
APPROVED	DATE	PROJECT



PRICHARD CREEK
RESTORATION PROJECT
PHASE 1 AS-BUILT




501 Portway Avenue, Suite 101
Hood River, OR 97031
541.386.9003
www.interfluve.com

AS-BUILT PROJECT AREA 2 (1 OF 3)

SHEET

4 OF 8

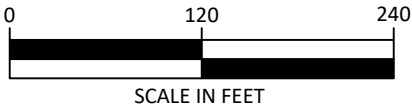

LEGEND

- PARCEL BOUNDARIES
- EXISTING ROADS
- 150+00 + — PRICHARD CREEK ALIGNMENT
- BAR REVEGETATION AREA

ABBREVIATIONS:

- BB- BANK BURIED
- CS- CHANNEL SPANNING
- DFL- DEFLECTOR
- ST- SALVAGED WHOLE TREES
- BRA- BAR REVEGATION AREA

G:\M:\P\PrichardCreek\PH1\Design - 210257\Drawings\AS-Built\PrichardCreek.dwg - bbroderick - 3/19/24

NO.	BY	DATE	REVISION DESCRIPTION

CM	LS, MC, SE	LS
DRAWN	DESIGNED	CHECKED
MC	3/18/2024	210257
APPROVED	DATE	PROJECT



PRICHARD CREEK
RESTORATION PROJECT
PHASE 1 AS-BUILT




501 Portway Avenue, Suite 101
Hood River, OR 97031
541.386.9003
www.interfluve.com

AS-BUILT PROJECT AREA 2 (2 OF 3)

SHEET
5 OF 8

G:\M:\P\PrichardCreek\PH1\Design - 210257\Drawings\AS-Built\PrichardCreek.dwg - bbroderick - 3/19/24

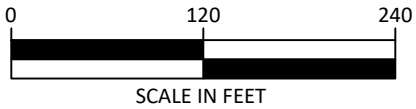

LEGEND

- PARCEL BOUNDARIES
- EXISTING ROADS
- 150+00
+ PRICHARD CREEK ALIGNMENT
- BAR REVEGETATION AREA

ABBREVIATIONS:

- BB- BANK BURIED
- CS- CHANNEL SPANNING
- DFL- DEFLECTOR
- ST- SALVAGED WHOLE TREES
- BRA- BAR REVEGETATION AREA

ACCESS FROM PRICHARD CREEK RD

NO.	BY	DATE	REVISION DESCRIPTION

CM DRAWN	LS, MC, SE DESIGNED	LS CHECKED
MC APPROVED	3/18/2024 DATE	210257 PROJECT



PRICHARD CREEK
RESTORATION PROJECT
PHASE 1 AS-BUILT




501 Portway Avenue, Suite 101
Hood River, OR 97031
541.386.9003
www.interfluve.com

AS-BUILT PROJECT AREA 2 (3 OF 3)

SHEET
6 OF 8

ACCESS FROM PRICHARD CREEK RD

G:\M:\P\PrichardCreek\PH1\Design - 210257\Drawings\AS-built\PrichardCreek.dwg - bbroderick - 3/19/24

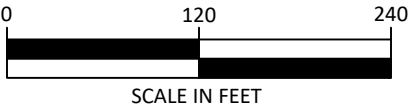

LEGEND

- PARCEL BOUNDARIES
- EXISTING ROADS
- 150+00 + PRICHARD CREEK ALIGNMENT
- BERM REMOVAL

ABBREVIATIONS:

- BB- BANK BURIED
- ST- SALVAGED WHOLE TREES

NO.	BY	DATE	REVISION DESCRIPTION

CM DRAWN	LS, MC, SE DESIGNED	LS CHECKED
MC APPROVED	3/18/2024 DATE	210257 PROJECT




PRICHARD CREEK
RESTORATION PROJECT
PHASE 1 AS-BUILT



501 Portway Avenue, Suite 101
Hood River, OR 97031
541.386.9003
www.interfluve.com

AS-BUILT PROJECT AREA 3

SHEET
7 OF 8

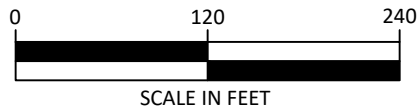

LEGEND

- PARCEL BOUNDARIES
- EXISTING ROADS
- 150+00
+ PRICHARD CREEK ALIGNMENT
- BAR REVEGETATION AREA

ABBREVIATIONS:

- ST- SALVAGED WHOLE TREES
- DFL- DEFLECTOR
- BRA- BAR REVEGETATION AREA



G:\M:\P\PrichardCreek\PH1\Design - 210257\Drawings\AS-Built\PrichardCreek.dwg - bbroderick - 3/19/24

NO.	BY	DATE	REVISION DESCRIPTION

CM	LS, MC, SE	LS
DRAWN	DESIGNED	CHECKED
MC	3/18/2024	210257
APPROVED	DATE	PROJECT



PRICHARD CREEK
RESTORATION PROJECT
PHASE 1 AS-BUILT



501 Portway Avenue, Suite 101
Hood River, OR 97031
541.386.9003
www.interfluve.com

AS-BUILT PROJECT AREA 4